PLS-CADD Drawing

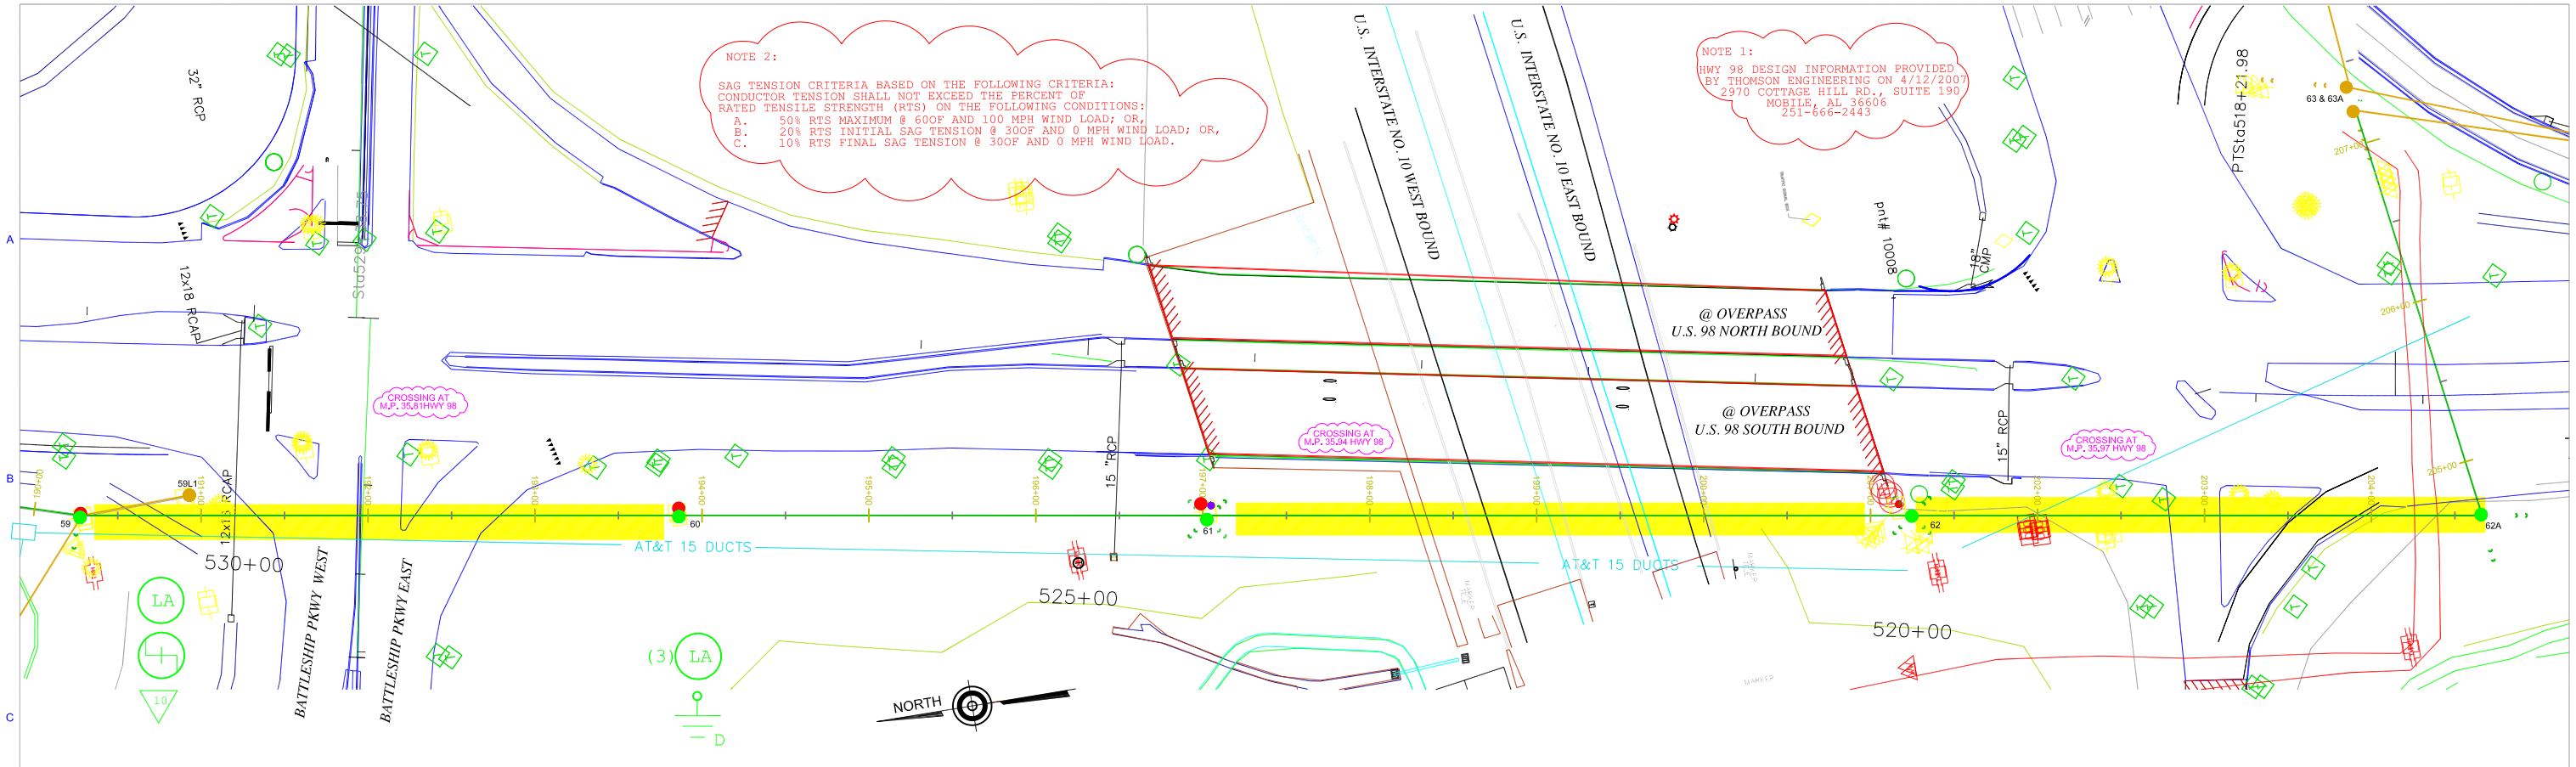

LEGEND:

FUTURE | REMOVE | NEW-INSTALL | TRANSFER | EXISTING | POLE REMOVAL | REMOVE CHANGE-OUT

- EXISTING POLE
- NEW POLE
- FUTURE POLE
- REMOVE POLE
- CHANGE OUT POLE
- EXISTING ANCHOR
- REMOVE ANCHOR
- NEW ANCHOR
- OVERHEAD GUY
- SECURITY LIGHT
- PI DEFLECTION ANGLE
- TRANSFORMER
- D.O.T. ROW
- Edge of Pavement
- Center Line
- Fence
- Utility Easement
- Line Underbuilt
- Line Underground

PROVEN GROUND | FUSE CUTOUT | LIGHTNING ARRESTOR | RECLOSER | CAPACITOR | REGULATOR

REV.	REVISION DESCRIPTION	MADE BY	CK'D BY	APP'D BY	DATE
5					
4					
3					
2					
1	NEW CROSSING #62 TO NEW POLE #62A	AD	FBN	MN	11/15/07

☒ -D.O.T.
☐ -BID
☐ -CONSTRUCTION
☐ -AS BUILT

THIS DRAWING OR BILL OF MATERIAL IS CONFIDENTIAL AND MAY NOT BE LOANED, REPRODUCED OR COPIED, EITHER WHOLLY OR IN PART, OR MADE PUBLIC IN ANY MANNER WITHOUT THE WRITTEN CONSENT OF RIVIERA UTILITIES.

RIVIERA UTILITIES

Spanish Fort D/L - US HWY 31 AND 98

SCALE	DATE	CWO NUMBER	DRAWING NUMBER	REV. NO.
AS SHOWN		W688 / W689	S/F-D/L-111407 Page 8/10	1

DRAWN BY	CHK'D. BY	APP'D. BY
AWT	FBN	MN